

PLANT STOCK TABULATION S.P. 7005-114				
KEY	SPECIES	Minimum Acceptable Dimensions	Units	TOTAL QUANTITY
	CONIFEROUS TREE 4' HT B&B	3.5' Ht., 2' Spread, 16" root spread & 12" depth	TOTAL	15
BHS	SPRUCE, BLACK HILLS		TREE	15
	<i>Picea glauca densata</i>			
	DECIDUOUS TREE 1.5" CAL BR	1.35" Cal., 6.5' Ht., 22" root spread	TOTAL	22
SWO	OAK, SWAMP WHITE		TREE	6
	<i>Quercus bicolor</i>			
CHB	HACKBERRY, COMMON		TREE	7
	<i>Celtis occidentalis</i>			
SIM	MAPLE, SIENNA GLEN		TREE	6
	<i>Acer x freemanii (Sienna)</i>			
MSO	OAK, MAJESTIC SKIES PIN SUBSTITUTE	KCT - KENTUCKY COFFEETREE 'ESPRESSO'	TREE	3
	<i>Quercus ellipsoidalis 'Majestic Skies'</i>			
	ORNAMENTAL TREE .75" CAL BR	0.60" Cal., 4' Ht., 16" root spread	TOTAL	39
ABS	SERVICEBERRY, AUTUMN BRILLIANCE SUBSTITUTE		TREE	39
	<i>Amelanchier x grandiflora (Autumn Brilliance)</i>			
	DECIDUOUS SHRUB 15" HT BR	13.5" Ht., 9" root spread	TOTAL	467
CMN	NINEBARK, COMMON		Shrub	76
	<i>Physocarpus opulifolius</i>			
GBC	CHOKEBERRY, GLOSSY BLACK		Shrub	64
	<i>Aronia melanocarpa</i>			
FGS	SUMAC, FRAGRANT		Shrub	30
	<i>Rhus aromatica</i>			
FLW	WILLOW, FLAME		Shrub	182
	<i>Salix (Flame)</i>			
SMS	SUMAC, SMOOTH		Shrub	115
	<i>Rhus glabra</i>			


		TREE	19
	1.35" Cal., 6.5' Ht., 22" root spread	TOTAL	22
		TREE	6
		TREE	7
		TREE	6
SUBSTITUTE	KCT - KENTUCKY COFFEETREE 'ESPRESSO'	TREE	3
	0.60" Cal., 4' Ht., 16" root spread	TOTAL	39
SUBSTITUTE		TREE	39
(Alliance)			
	13.5" Ht., 9" root spread	TOTAL	467
		Shrub	76
		Shrub	64
		Shrub	30
		Shrub	182
		Shrub	115

ACC - AMUR CHOKECHERRY (9)


RRC - ROYAL RAINDROPS CRABAPPLE (16)

SSC - SPRING SNOW CRABAPPLE (8)

PKP - PRINCESS KAY PLUM (6)

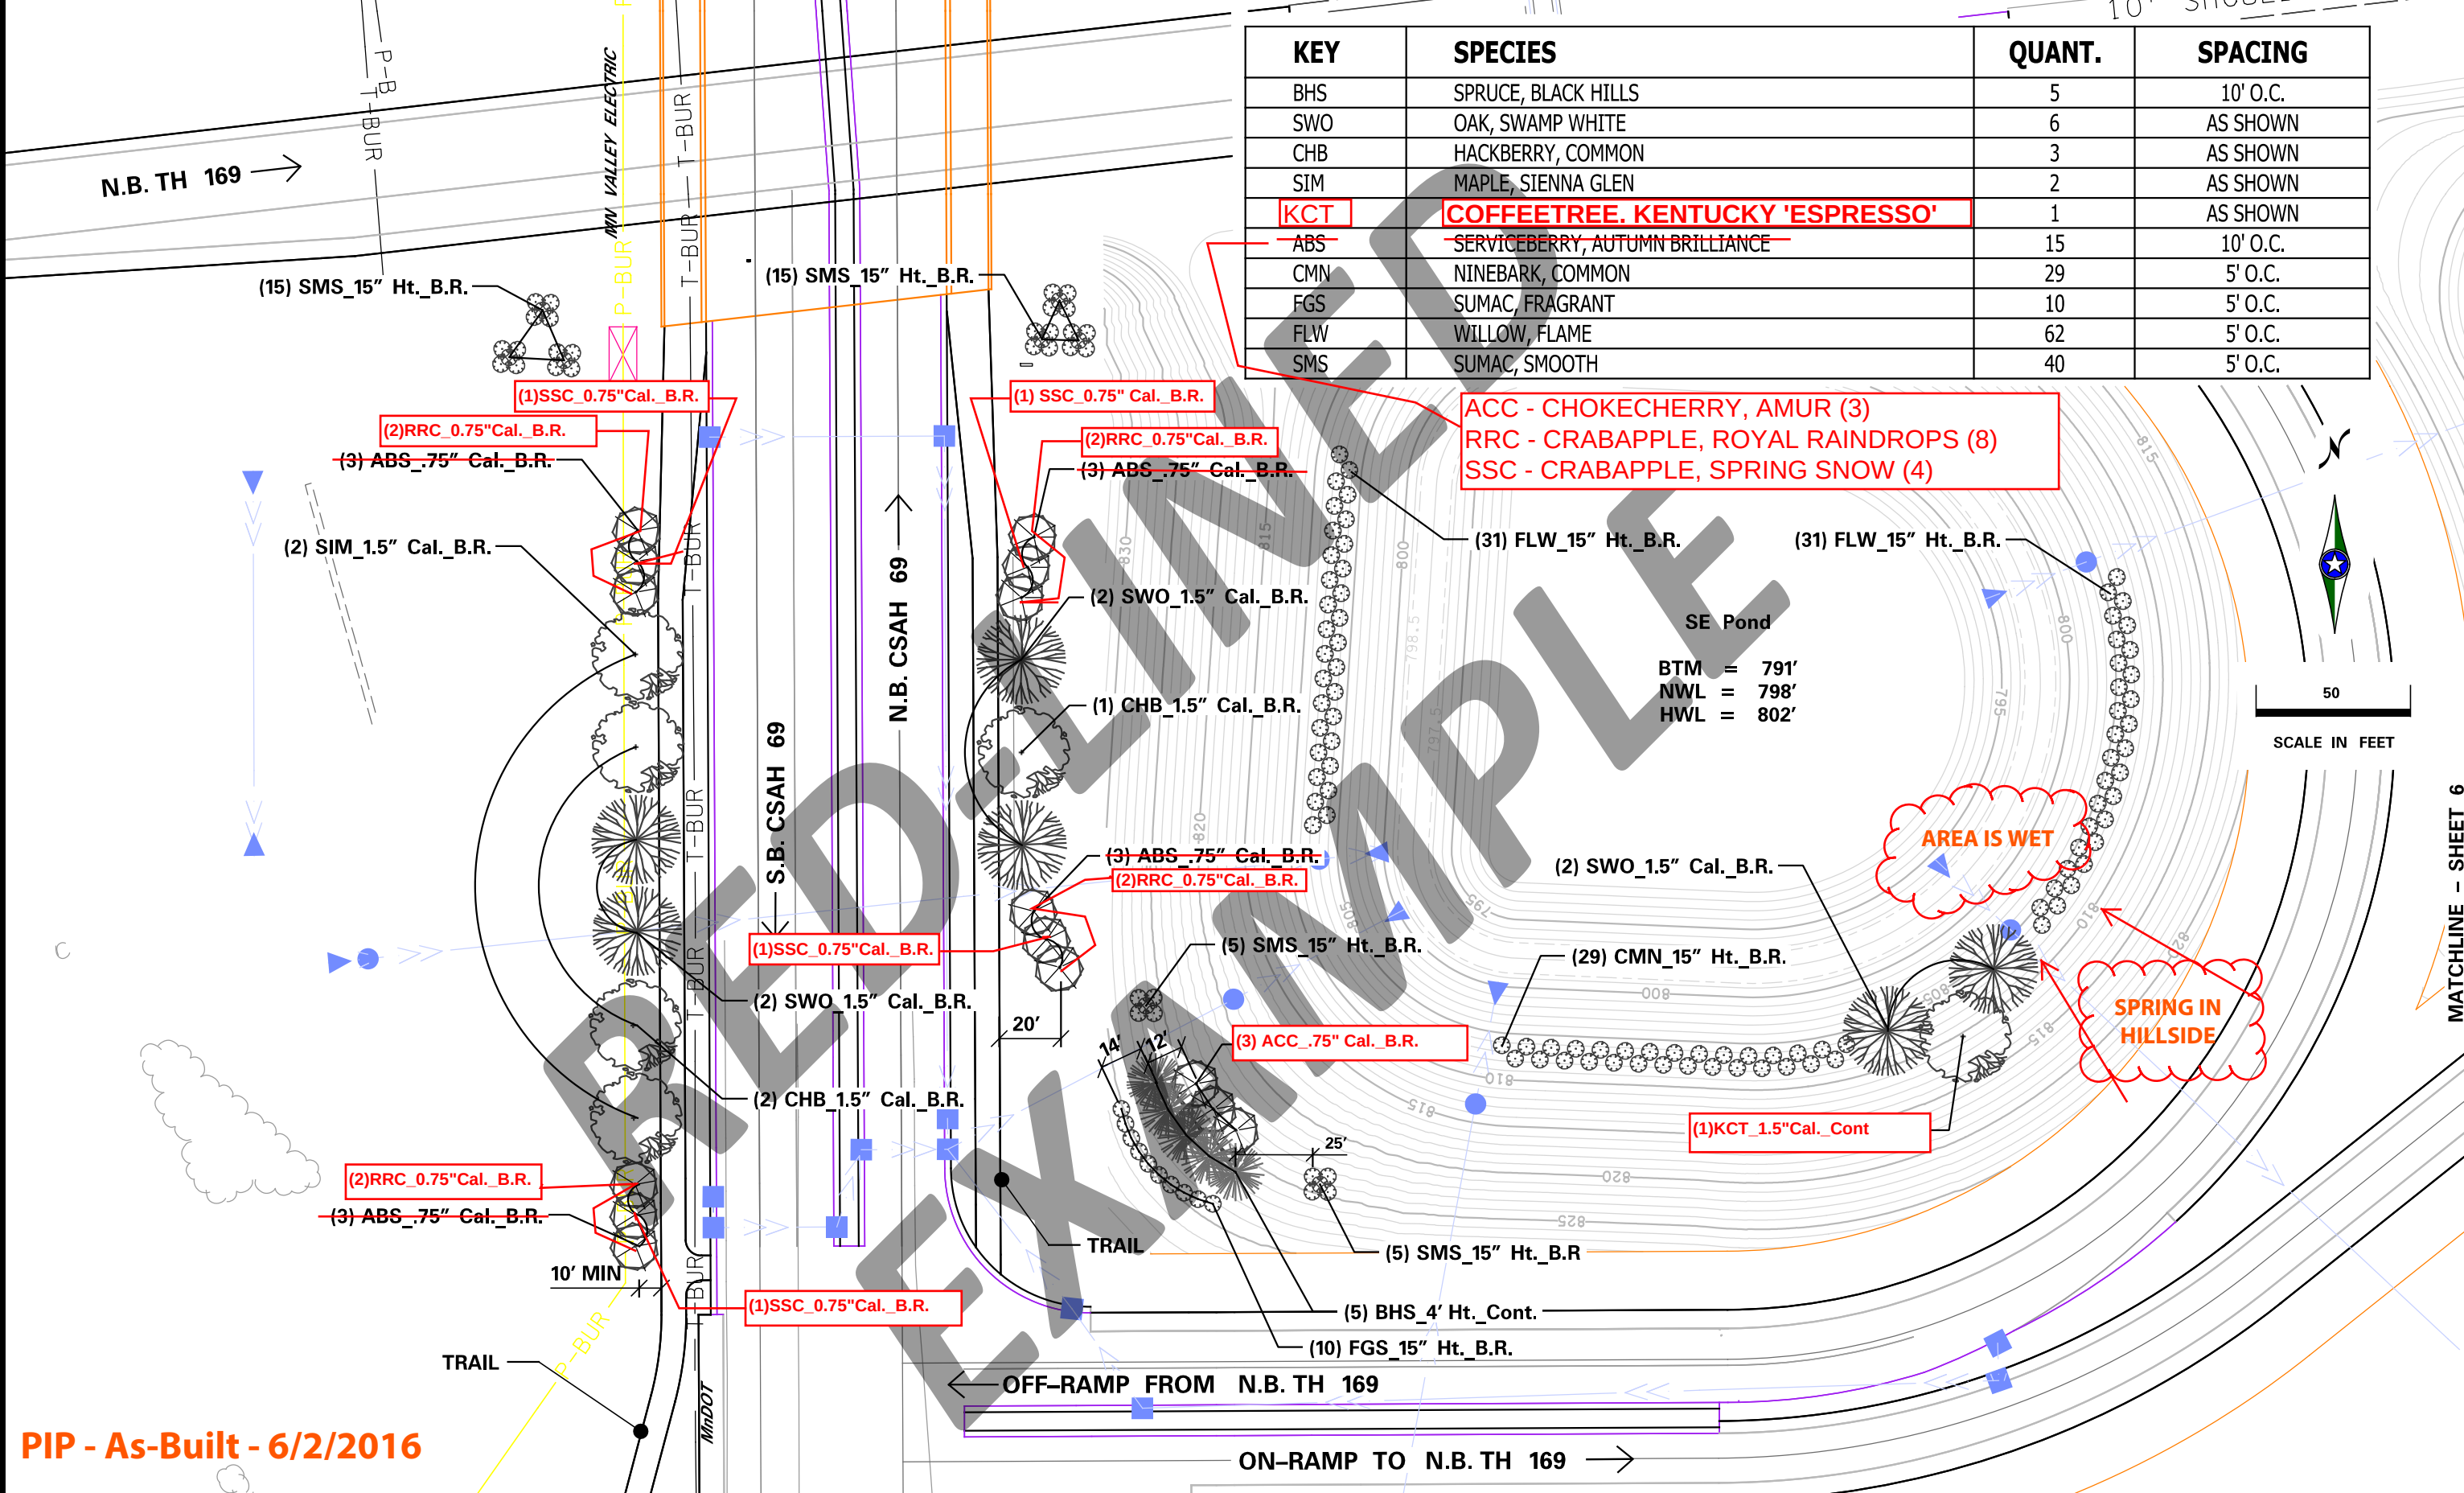

PIP - As-Built - 6/2/2016

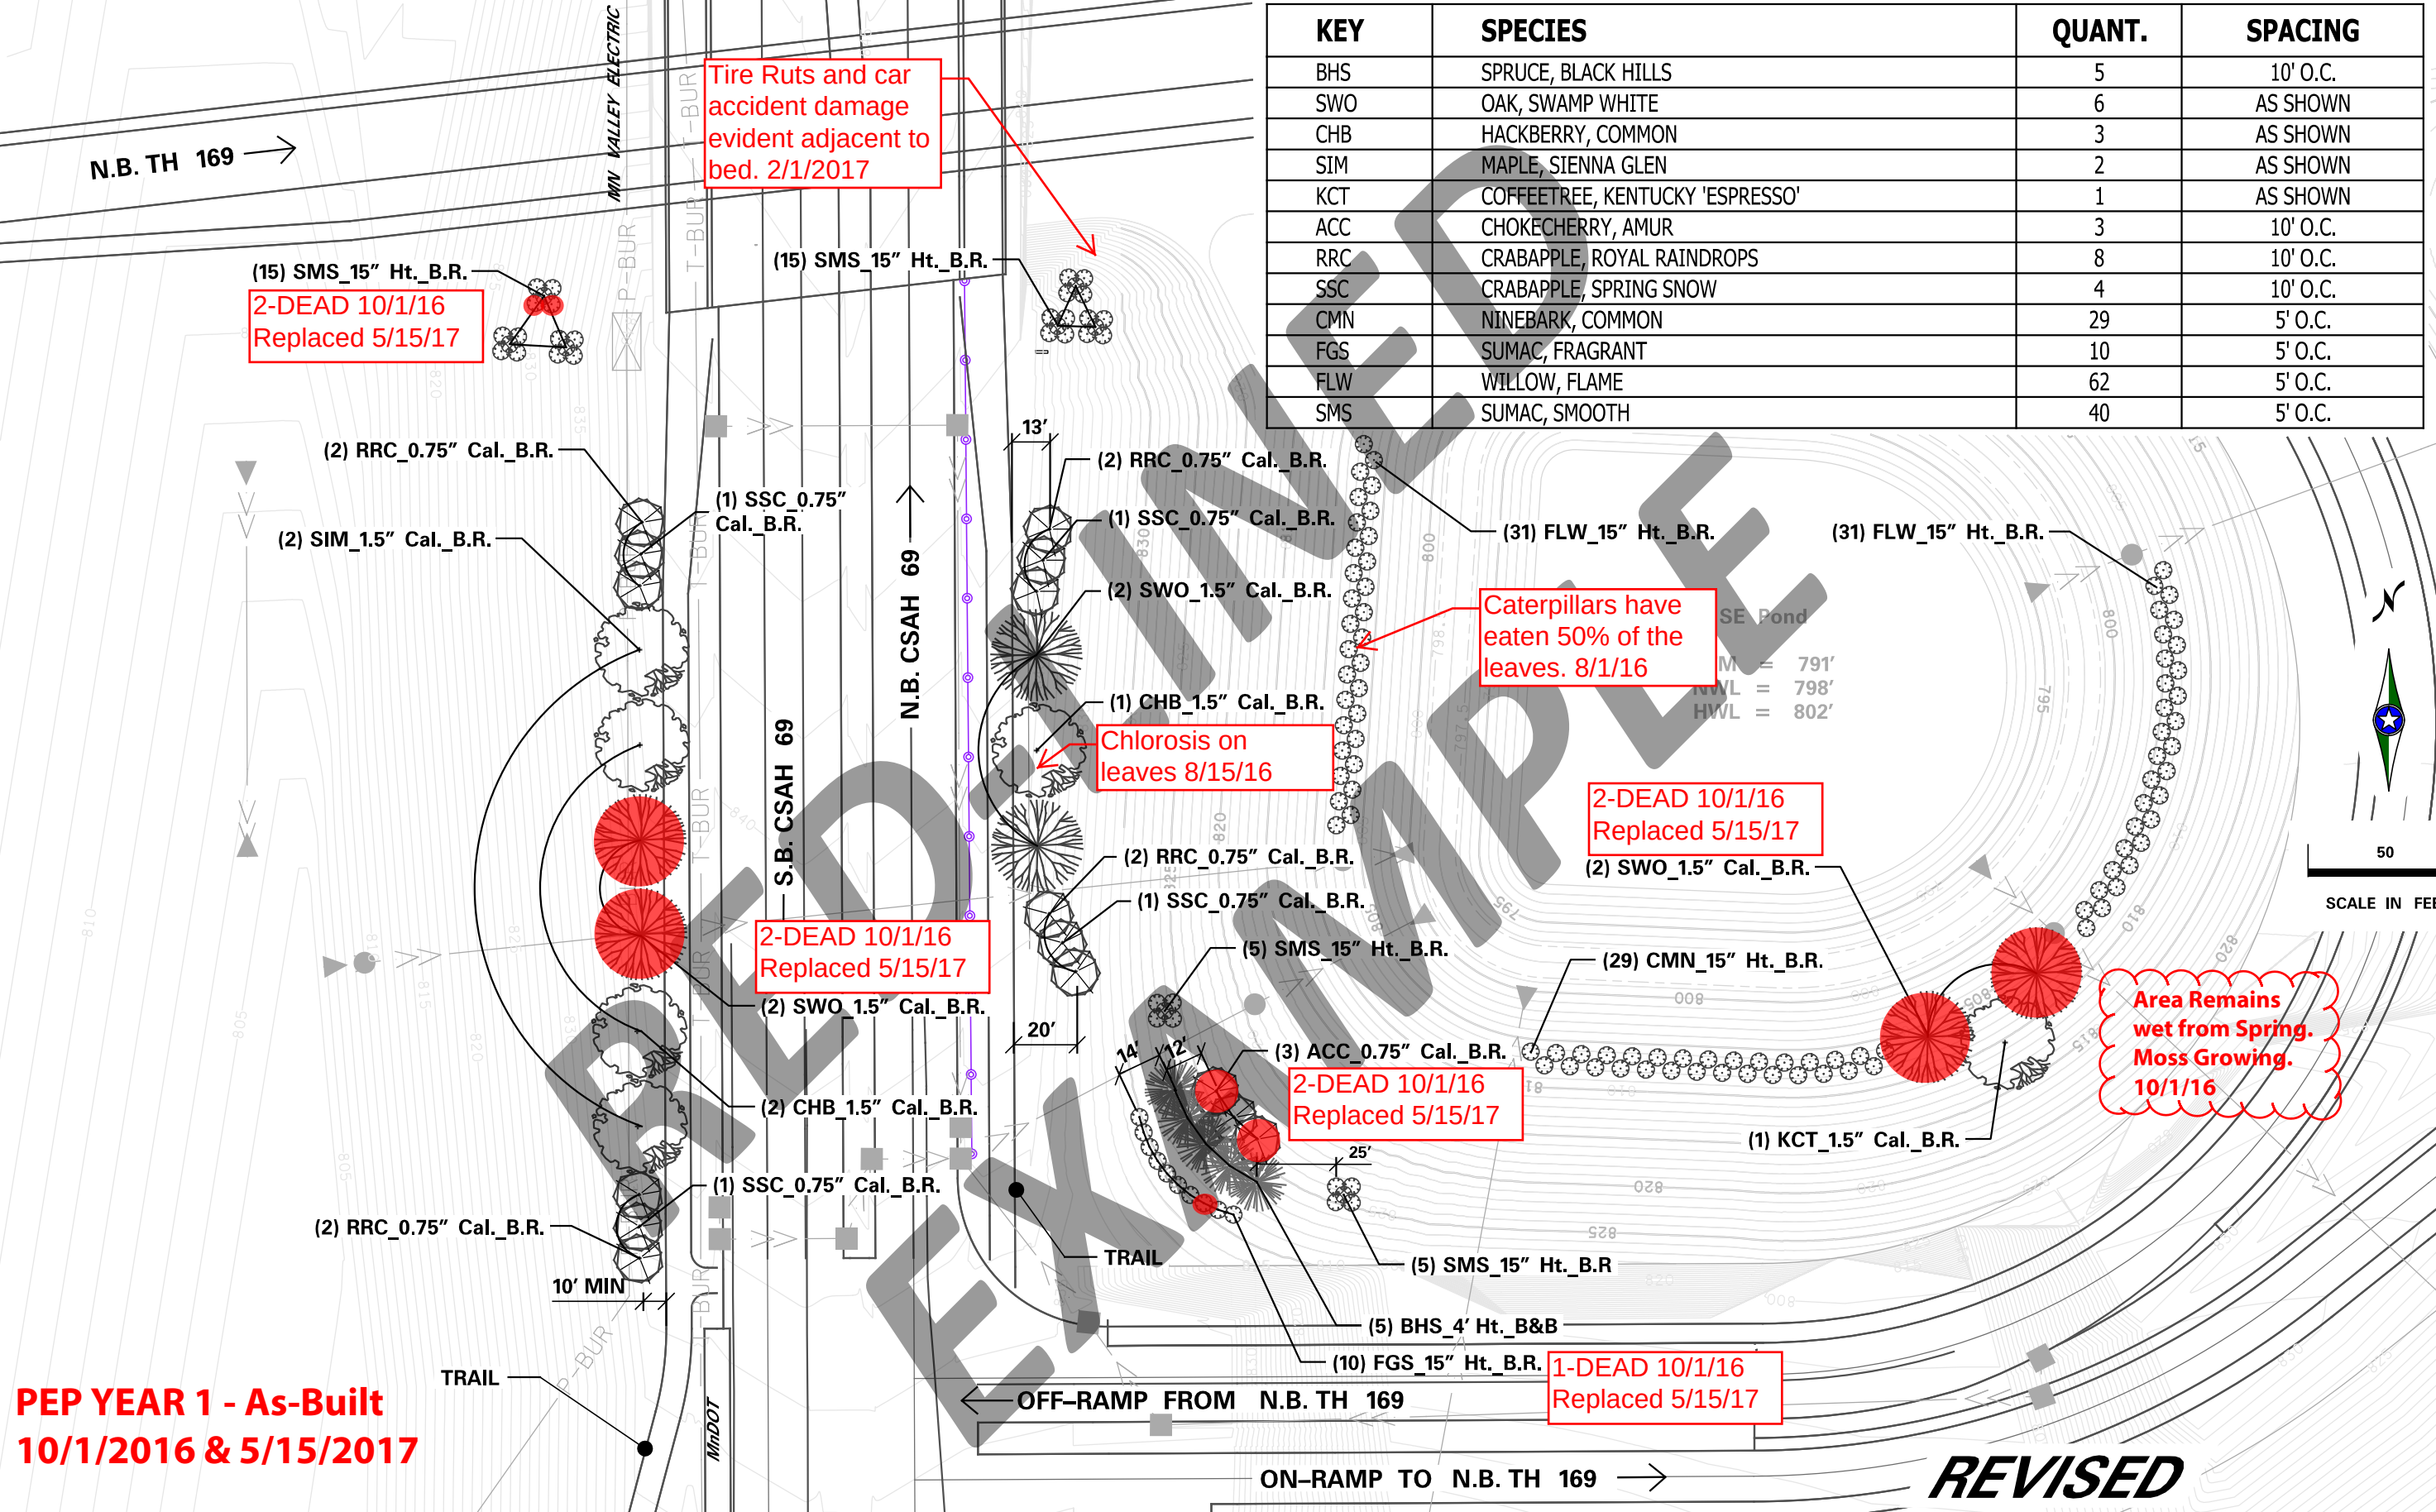

PEP YEAR 1 - As-Built
10/1/2016 & 5/15/2017

KEY	SPECIES	QUANT.	SPACING
BHS	SPRUCE, BLACK HILLS	5	10' O.C.
SWO	OAK, SWAMP WHITE	6	AS SHOWN
CHB	HACKBERRY, COMMON	3	AS SHOWN
SIM	MAPLE, SIENNA GLEN	2	AS SHOWN
KCT	COFFEETREE, KENTUCKY 'ESPRESSO'	1	AS SHOWN
ACC	CHOKECHERRY, AMUR	3	10' O.C.
RRC	CRABAPPLE, ROYAL RAINDROPS	8	10' O.C.
SSC	CRABAPPLE, SPRING SNOW	4	10' O.C.
CMN	NINEBARK, COMMON	29	5' O.C.
FGS	SUMAC, FRAGRANT	10	5' O.C.
FLW	WILLOW, FLAME	62	5' O.C.
SMS	SUMAC, SMOOTH	40	5' O.C.

DATE PRINTED: 4/15/2016	TIME PRINTED: 10:53:59 AM	PROJECT MANAGER TONY WOTZKA	DRAWN BY TONY WOTZKA	DATE <u>10-8-2015</u> LIC. NO. <u>24237</u>	 STATE OF MINNESOTA DEPARTMENT OF TRANSPORTATION OFFICE OF ENVIRONMENTAL STEWARDSHIP ENV. PLANNING AND DESIGN UNIT TRANSPORTATION BUILDING ST. PAUL, MINNESOTA 55155-1899	LANDSCAPE PLAN			
			CHECKED BY DENNIS MOLINE	SIGNATURE _____ LICENSED PROFESSIONAL LANDSCAPE ARCHITECT		STATE PROJECT 7005-114 (T.H. 169)	SHEET NO. 5 OF 13 SHEETS		