


**CORRECTION OF PLAN SHEETS (AS-BUILT PLANS)**

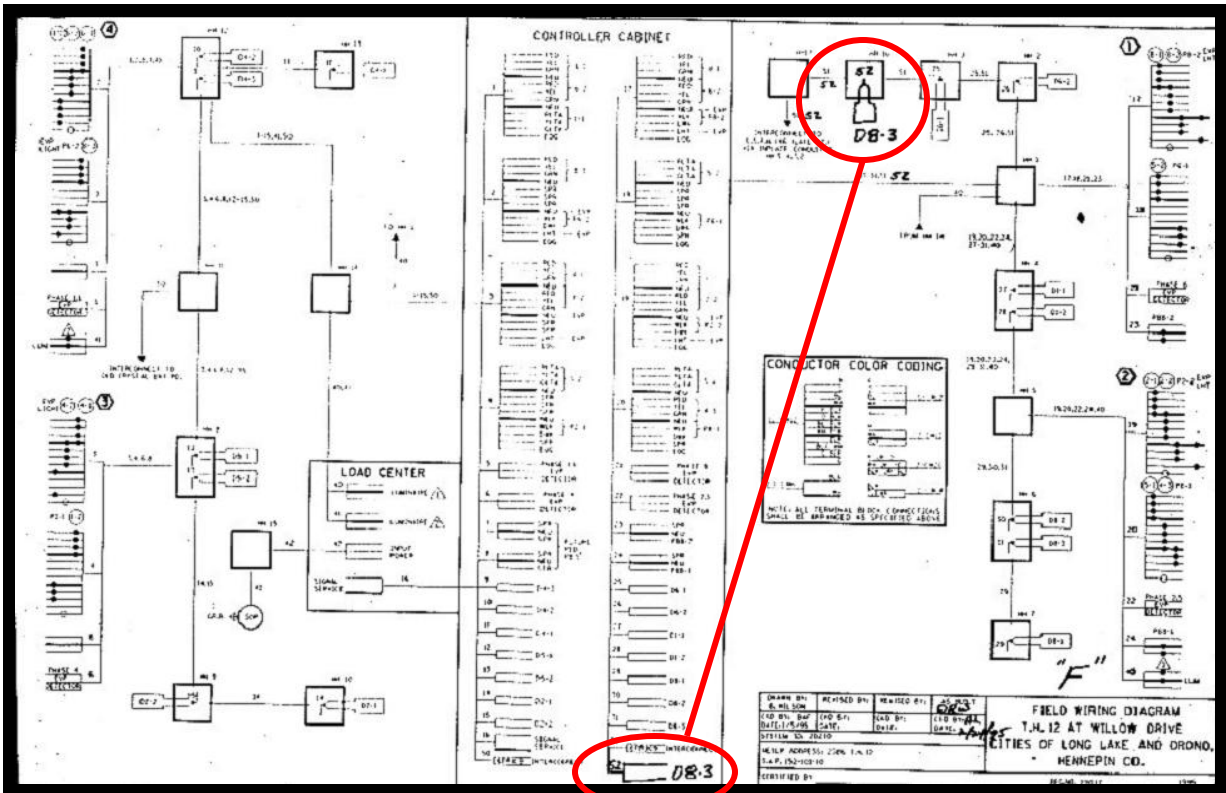

If specified in the Contract Documents (Special Provisions), the Contractor shall furnish “as built Plans” that contain any changes in the following:

- |     |                                    |     |   |
|-----|------------------------------------|-----|---|
| --- | pole locations                     | --- | handhole locations                      |
| --- | length of mast arms                | --- | types of handholes                      |
| --- | signal bracketing or signal mounts | --- | wiring                                  |
| --- | conduit sizes                      | --- | size of detection                       |
| --- | conduit runs                       | --- | type of detection                       |
| --- | number of handholes                | --- | cable path                              |
|     |                                    | --- | other items as required by the Engineer |

Any discrepancy or change(s) between the final plan and how the signal was actually built must be indicated on the “as built plan”.

The “as built Plans” shall be in a form that is satisfactory to the Engineer.

A copy of the corrected plans shall be sent to the District Traffic office and Electrical Service Unit (ESU) at Fort Snelling.